

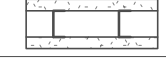
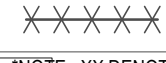
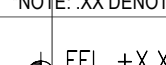

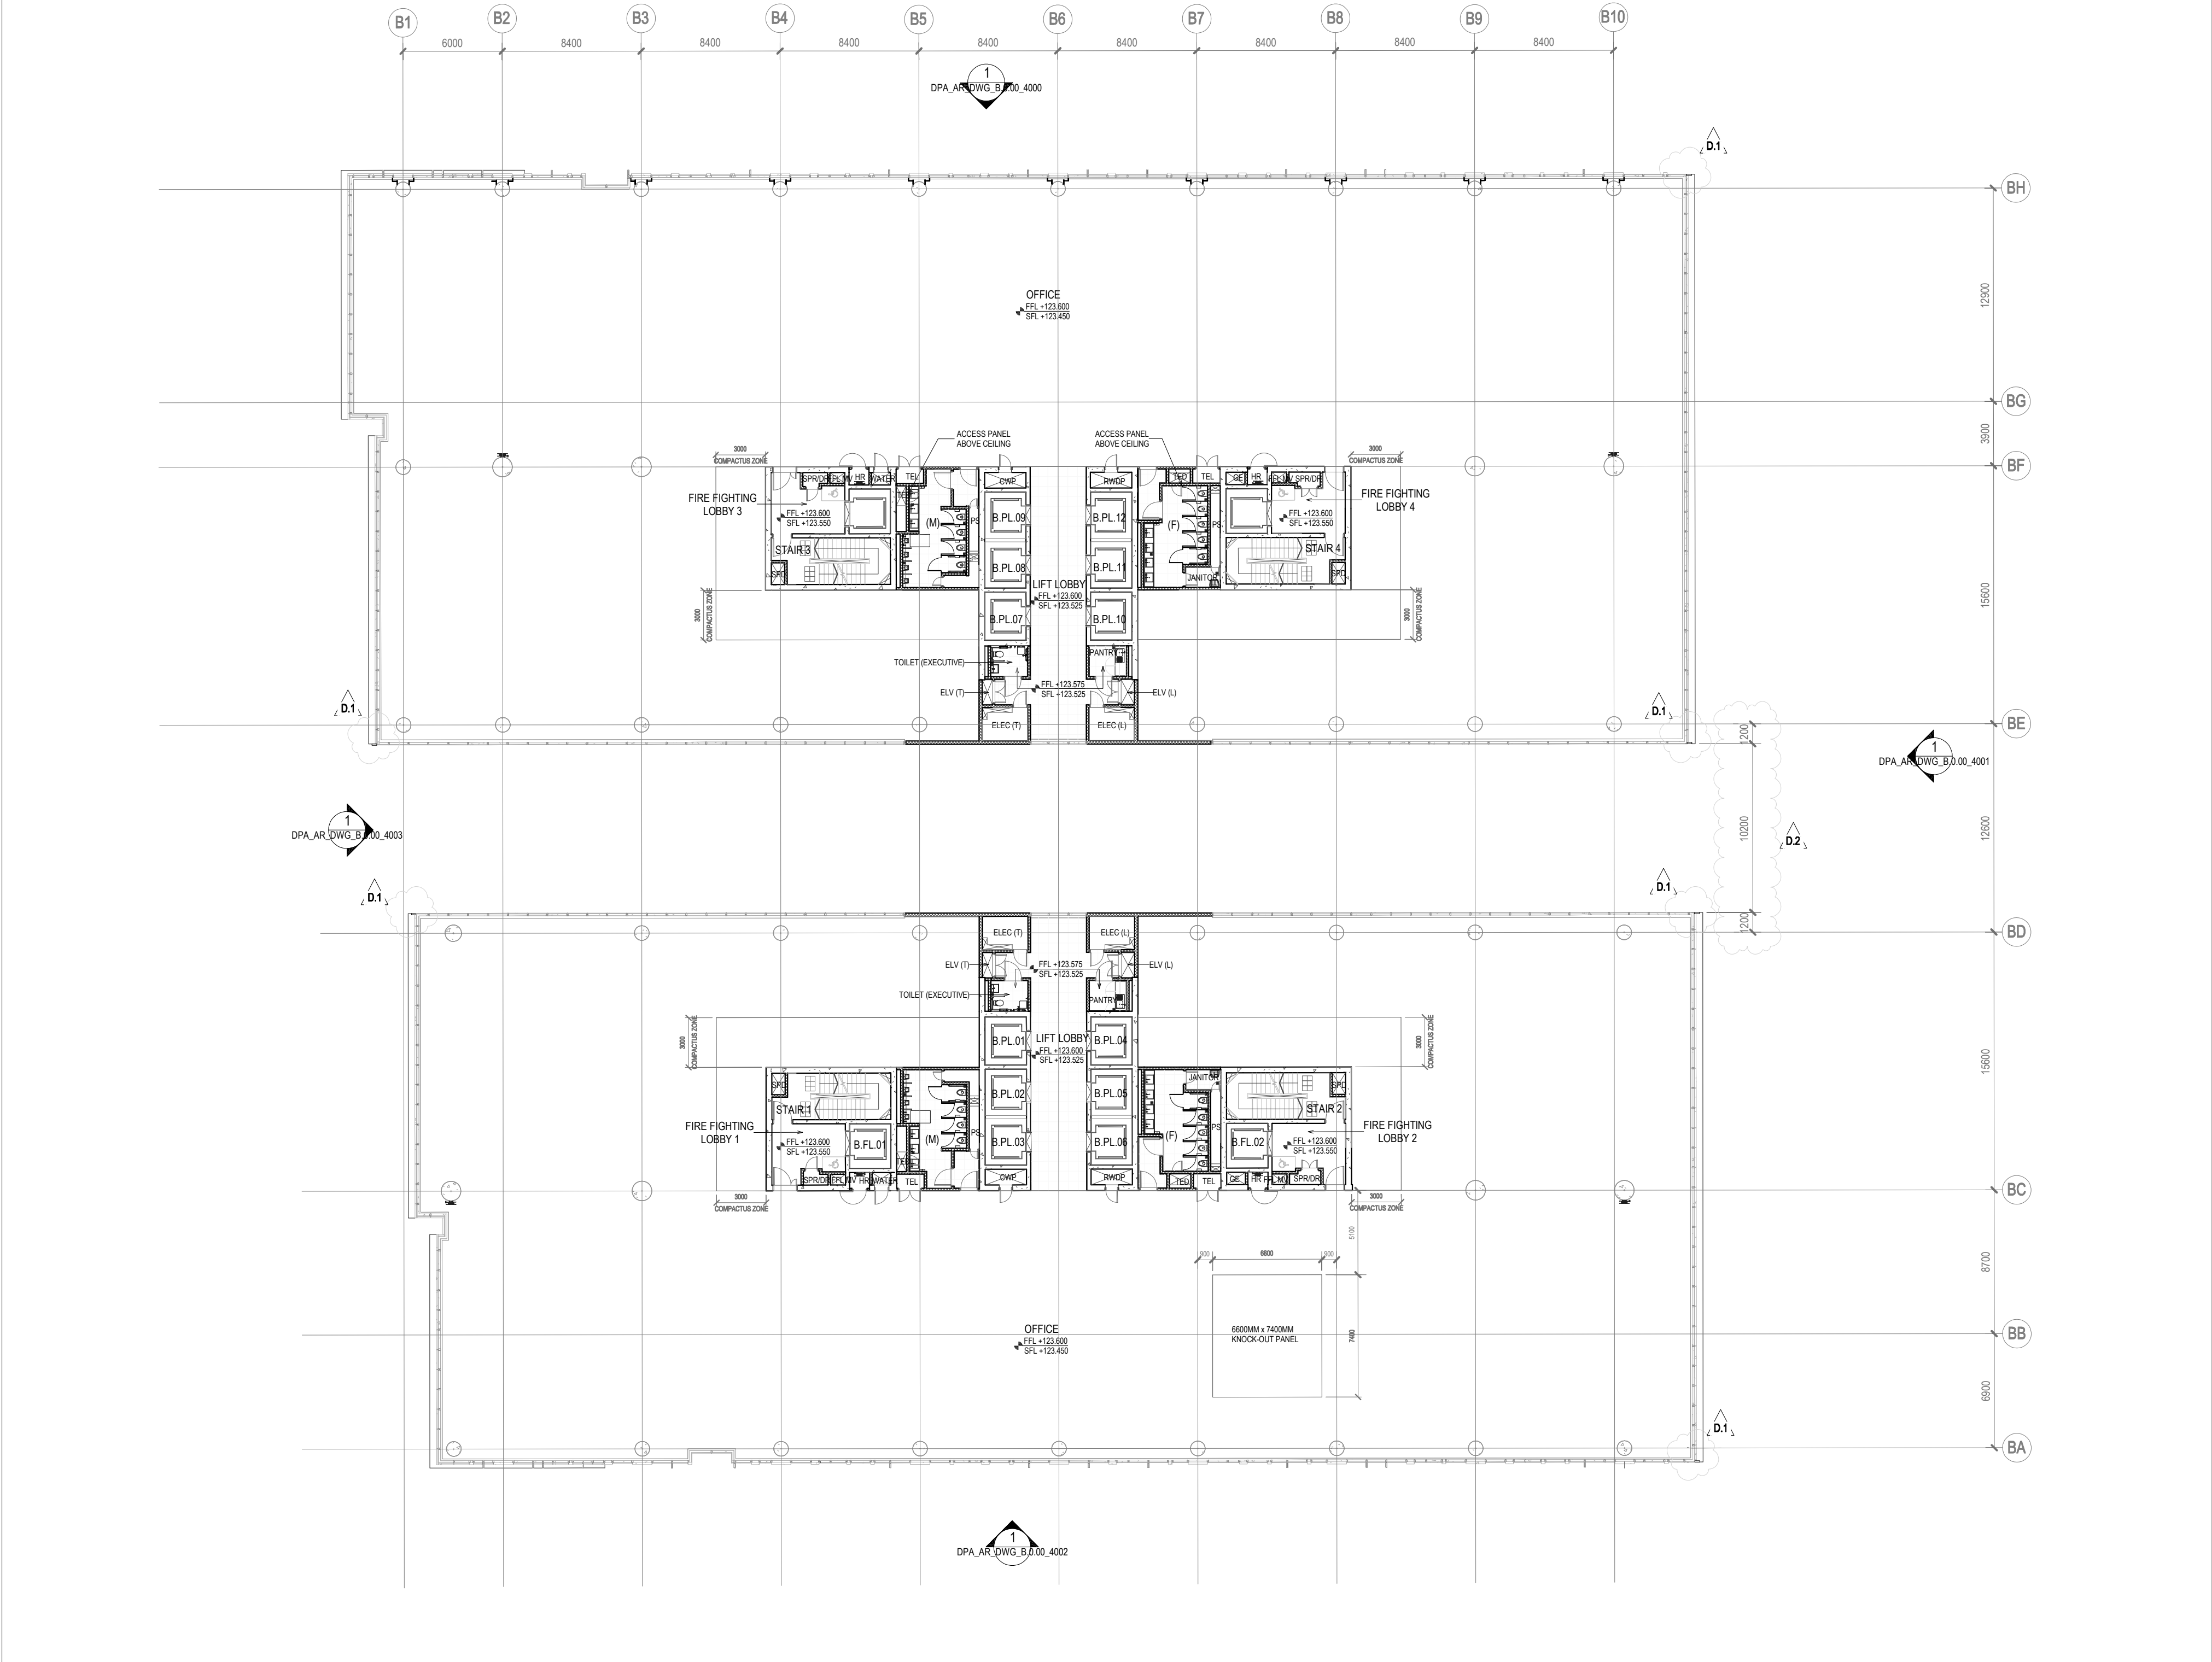


GENERAL NOTES/LEGENDS	DATE	REV	DESCRIPTION
	10 DEC 2015	-	ISSUED FOR GMP
	22 JAN 2016	1	ISSUED FOR AFT
	26 FEB 2016	A	PLANTER ADJUSTED AND RWDP ADDED
	08 APR 2016	B.1	ISSUED FOR IFC
	14 APR 2016	B.2	LIFT OPENING REVISED & FFL LAYOUT AMENDED
	20 APR 2016	B	PLANTER OMITTED
	20 MAY 2016	B	ISSUED FOR AFC
	05 APR 2017	C.1	ELV (L) RISER WIDTH CHANGED
		C.2	SHAFT REMOVED
		D.1	ISSUED FOR AFC
		D.2	EDGE VERTICAL FINIS CAPPING SHOWN
		D	DIMENSION PROVIDED
			ISSUED FOR AFC
*NOTE: XX DENOTES THICKNESS			
*NOTE: XX DENOTES LEVELS			



1 6TH STOREY - PLOT B
PLAN SCALE 1:250

DEVELOPER/ LANDOWNER:

ROMA CENTRAL PTE LTD
MILANO CENTRAL PTE LTD
VERONA CENTRAL PTE LTD
60 Anson Road, #17-01 Mapletree Anson
Singapore 07991

ARCHITECTURAL:

 DP ARCHITECTS PTE LTD
6 RAFFLES BOULEVARD
#04-100 MARINA SQUARE
SINGAPORE 039594
TEL: +65 6336 3988 FAX: +65 6337 9989

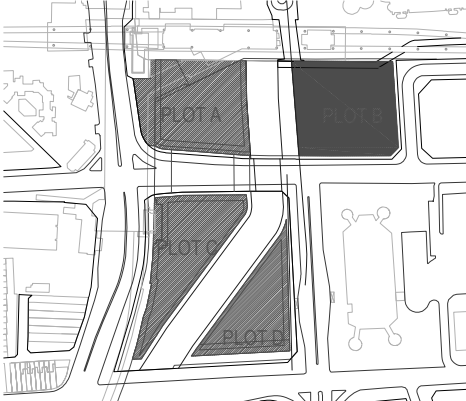
CIVIL & STRUCTURAL ENGINEER:

ARUP SINGAPORE PTE. LTD.
10 Hoe Chiang Road, #26-01 Keppel Towers Singapore 089315

MECHANICAL & ELECTRICAL ENGINEER:

MEINHARDT SINGAPORE PTE. LTD.
168 Jalan Bukit Merah #09-01 Surbana One Singapore 150168

KEY PLAN



PROJECT ADDRESS

PROPOSED MIXED-USE COMMERCIAL DEVELOPMENT
COMPRISING 1 BLOCK 7 STOREY CUM 2 BASEMENTS
SHOPPING MALL WITH 3 BASEMENTS CARPARKS (TOTAL
3 STRATA UNITS), 2 BLOCKS 14 STOREY AND 1 BLOCK 13
STOREY OFFICES (TOTAL 5 STRATA UNITS), 3 BLOCKS
17 STOREY RESIDENTIAL FLATS (TOTAL 429 UNITS), 1ST
STOREY RETAIL, 3 NOS DRAINAGE RESERVES, MULTI-
STOREY CARPARKS WITH AIRSPACE/SUBTERRANEAN
CONNECTIONS ACROSS SIMS AVENUE ON LOTS 6991M,
7373T, 70006P & 80007T MK23 AT PAYA LEBAR
ROAD/SIMS AVENUE (GEYLANG PLANNING AREA)

DRAWING TITLE

PLOT B
6TH STOREY PLAN

SCALE @ A1 As indicated	DATE 07/12/15	DESIGNED DPA	DRAWN EC
STAGE CN	CONTRACT	CHECKED CKP	APPROVED CML

JOB NO. SG15A.0067	DRAWING NO. DPA_AR_DWG_B.0.06_1100	REV. D
-----------------------	---------------------------------------	-----------

ISSUED FOR AFC

05 APR 2017

DP Architects Pte Ltd

THIS DRAWING IS THE PROPERTY OF DP ARCHITECTS PTE LTD
NO PART OF THE DRAWING MAY BE REPRODUCED IN ANY MANNER
WHATSOEVER WITHOUT PERMISSION FROM DP ARCHITECTS PTE LTD