

[illegible]

DOOR TAG INFORMATION	
	DOOR TYPE IRONMONGERY SET
	IRONMONGERY SET
	DOOR MATERIAL
	DOOR FINISH
	DOOR PANEL DIMENSION (WIDTH x HEIGHT x THICKNESS)
	DOOR STRUCTURE
	FIRE RATING
	SECURITY LEGEND
	THRESHOLD TYPE
	SO STAY OPEN (Linked to alarm)
	SO M-STAY OPEN (not Linked to alarm)
	FRAME TYPE
GENERAL NOTES / LEGENDS	
	CW XX - CONCRETE WALL
	PCXX - LIGHT WEIGHT SOLID CORE PRECAST CONCRETE PANEL
	DW XX DRYWALL W/ 20MM "PROTECT" OR EQUIVALENT ON BOTH SIDES ON METAL STUDS
*****	PVC XX - POLYVINYL CHLORIDE COATED 100/100MM MESH FENCING
*NOTE	XX DENOTES THICKNESS
	FFL = XXX → FINISH FLOOR LEVEL
	SFL = XXX → STRUCTURE FLOOR LEVEL
DOOR TAG INFORMATION	
	DOOR TYPE IRONMONGERY SET
	IRONMONGERY SET
	DOOR MATERIAL
	DOOR FINISH
	DOOR PANEL DIMENSION (WIDTH x HEIGHT x THICKNESS)
	DOOR STRUCTURE
	FIRE RATING
	SECURITY LEGEND
	THRESHOLD TYPE
	SO STAY OPEN (Linked to alarm)
	SO M-STAY OPEN (not Linked to alarm)
	FRAME TYPE
DOOR TYPE CODE	
DT 23	1 FLUSH TYPE
	2 WITH VISION PANEL
DOOR TYPE	
GS	GALVANISED STEEL
SS	STAINLESS STEEL
T	TIMBER
G	GLASS
SECURITY LEGEND	
MC	MAGNETIC CONTACT
EMK	ELECTRO MAGNETIC LOCK w/ MAGNETIC CONTACT & EMERGENCY BREAK GLASS
CR	CARD READER w/ ELECTROMAGNETIC LOCK, MAGNETIC CONTACT, PUSH BUTTON & EMERGENCY BREAK GLASS
CR2	SAME AS CR BUT FIXED ON BOTH SIDE
DOOR FINISH	
P	PAINT
IRONMONGERY SET	
SPD-X	SLIDING POCKET DOOR
SLD-X	SLIDING DOOR
SP-X	STAIR PASSAGE
PR-X	PLANT ROOM
PA-X	PRIVATE ACCESS
CA-X	CONTROLLED ACCESS
TE-X	TOILET
HR-X	HOSEREEL
SD-X	SERVICE DUCTS / SHAFTS
PD-X	PANIC DEVICE
HC-X	HANDICAPPED COMPLAINT
SE-X	SERVICE SHAFT WITH FIRE EXTINGUISHER INSIDE
WR-X	DRY RISER
XT-X	EXIT DOOR
DS-X	DOUBLE SWING
BSO	DOUBLE SWING
*NOTE : X DENOTES THICKNESS	
REFER TO STRUCTURE CONCRETE BOY PLAN FOR STRUCTURE OPENING OF CONCRETE WALL	

COMPANY: DP ARCHITECTS PTE LTD	
NAME & DESIGNATION	SIGNATURE

COMPANY: ARUP SINGAPORE PTE LTD	
NAME & DESIGNATION	SIGNATURE

RTO NAME	SIGNATURE
----------	-----------

COMPANY: MEINHARDT SINGAPORE PTE LTD	
NAME & DESIGNATION	SIGNATURE

RTO NAME	SIGNATURE
----------	-----------

COMPANY:

NAME & DESIGNATION	SIGNATURE

COMPANY:	
NAME & DESIGNATION	SIGNATURE


COMPANY: HEXACON CONSTRUCTION PTE LTD

NAME & DESIGNATION	SIGNATURE
--------------------	-----------

SUB CONTRACTOR : \_\_\_\_\_

NAME & DESIGNATION	SIGNATURE
--------------------	-----------

## KEY PLAN

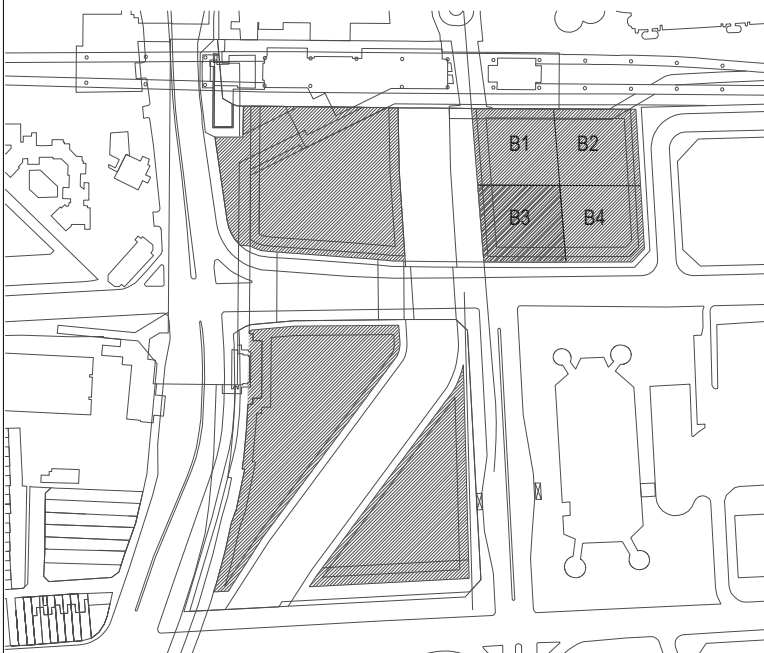

DEVELOPER/LANDOWNER:

ROMA CENTRAL PTE LTD  
MILANO CENTRAL PTE LTD  
VERONA CENTRAL PTE LTD  
60 ANSON ROAD, #17-01, MAPLETREE  
ANSON, SINGAPORE 079914  
TEL: +65 6671 6600 FAX: +65 6238 5301

ARCHITECTURAL:

---

DP ARCHITECTS PTE LTD  
6 RAFFLES BOULEVARD #04-100 MARINA  
SQUARE, SINGAPORE 039594  
TEL: +65 6338 3988 FAX: +65 6337 9989

**CIVIL & STRUCTURAL ENGINEER:**

ARUP SINGAPORE PTE LTD  
10 HOE CHIANG ROAD, #26-01,  
SINGAPORE 089315  
TEL: +65 6411 2500 FAX: +65 6411 2501

M&E ENGINEER: MEINHARDT SINGAPORE PTE LTD  
168 JALAN BUKIT MERAH. #09-01, SURBANA  
ONE, SINGAPORE 150168  
TEL: +65 6273 5255 FAX: +65 6274 0788

# MAIN CONTRACTOR

432 BALESTIER ROAD #02-432, PUBLIC MANSION SINGAPORE 329813  
TEL: 6251 9288 FAX: 6253 1638  
T/X: RS 38737  
E-MAIL: [hexacon@hexacon.com.sg](mailto:hexacon@hexacon.com.sg)

PROJECT TITLE:  
PROPOSED MIXED-USE COMMERCIAL DEVELOPMENT COMPRISING  
SHOPPING OFFICE / RESIDENTIAL AND CARPARKS WITH AIRSPACE  
SUBTERRANEAN CONNECTIONS ACROSS SIMS AVENUE ON LOTS  
6991M & 7373T MK23 AT PAYA LEBAR ROAD / SIMS AVENUE  
(GEYLANG PLANNING AREA)

DRAWING TITLE:  
WALL AND KERB SETTING OUT  
6TH STOREY \_ PLOT B3

DRAWN BY: GREG / YING-YING

CHECKED BY: EROS

APPROVED BY: JASON

DRAWING NO: HEX\_AR\_SHD\_B.8400.06.3

PROJECT NO: 251878	DATE: 25-08-17
--------------------	----------------

SCALE:	PAPER SIZE	SHEET NO	REV
--------	------------	----------	-----

1:100	A1	WSO-23	AA
-------	----	--------	----