

COMPANY: DP ARCHITECTS PTE LTD	
NAME & DESIGNATION	SIGNATURE

COMPANY: ARUP SINGAPORE PTE LTD	
NAME & DESIGNATION	SIGNATURE

RTO NAME		SIGNATURE

COMPANY: MEINHARDT SINGAPORE PTE LTD	
NAME & DESIGNATION	SIGNATURE

RTO NAME		SIGNATURE

COMPANY:	
NAME & DESIGNATION	SIGNATURE

COMPANY:	
NAME & DESIGNATION	SIGNATURE

COMPANY: HEXACON CONSTRUCTION PTE LTD	
NAME & DESIGNATION	SIGNATURE

SUB CONTRACTOR: _____

NAME & DESIGNATION	SIGNATURE

ROMA CENTRAL PTE LTD
MILANO CENTRAL PTE LTD
VERONA CENTRAL PTE LTD
60 ANSON ROAD, #17-01, MAPLETREE
ANSON, SINGAPORE 079914
TEL: +65 6671 6600 FAX: +65 6238 5301

DP ARCHITECTS PTE LTD
6 RAFFLES BOULEVARD #04-100 MARINA
SQUARE, SINGAPORE 039594
TEL: +65 6338 3988 FAX: +65 6337 9989

ARUP SINGAPORE PTE LTD
10 HOE CHIANG ROAD, #26-01,
SINGAPORE 089315
TEL: +65 6411 2500 FAX: +65 6411 2501

MEINHARDT SINGAPORE PTE LTD
168 JALAN BUKIT MERAH, #09-01, SURBANA
ONE, SINGAPORE 150168
TEL: +65 6273 5255 FAX: +65 6274 0788

\\VNLBLL2P\Drawings\PUBLISHED\PLT-FIGS\45-BUST\WDS\TEXTUAL\wall_SETTING-QUTL6REV_A\FHCL_M_10H_3-0-06_RVT-rvt_Muryfbeer-HEBAC2b-23233M.plt

432 BALESTIER ROAD #02-432, PUBLIC MANSION SINGAPORE 329813
TEL: 6251 9288 FAX: 6253 1638
T/X: RS 38737
E-MAIL: hexacon@hexacon.com.sg

PROJECT TITLE:
PROPOSED MIXED-USE COMMERCIAL DEVELOPMENT COMPRISING
SHOPPING OFFICE / RESIDENTIAL AND CARPARKS WITH AIRSPACE
SUBTERRANEAN CONNECTIONS ACROSS SIMS AVENUE ON LOTS
6991M & 7373T MK23 AT PAYA LEBAR ROAD / SIMS AVENUE
(GEYLANG PLANNING AREA)

DRAWING TITLE:

WALL AND KERB SETTING OUT
6TH STOREY _ PLOT B4

RESEARCHER	STEFAN J. HALL
------------	----------------

DRAWN BY:	GREG / YING-YING
-----------	------------------

CHECKED BY: EROS

APPROVED BY:	JASON
--------------	-------

DRAWING NO: HEY AP SHD B 8100 06.1


PROJECT NO. 051070	DATE 11/22/12
--------------------	---------------

PROJECT NO: 251878	DATE: 11/03/16
--------------------	----------------

SCALE:	PAPER SIZE	SHEET NO	REV
--------	------------	----------	-----

1 · 100	A1	WSQ-24	AA
---------	----	--------	----

11100	AT	W00-24	7/11
-------	----	--------	------

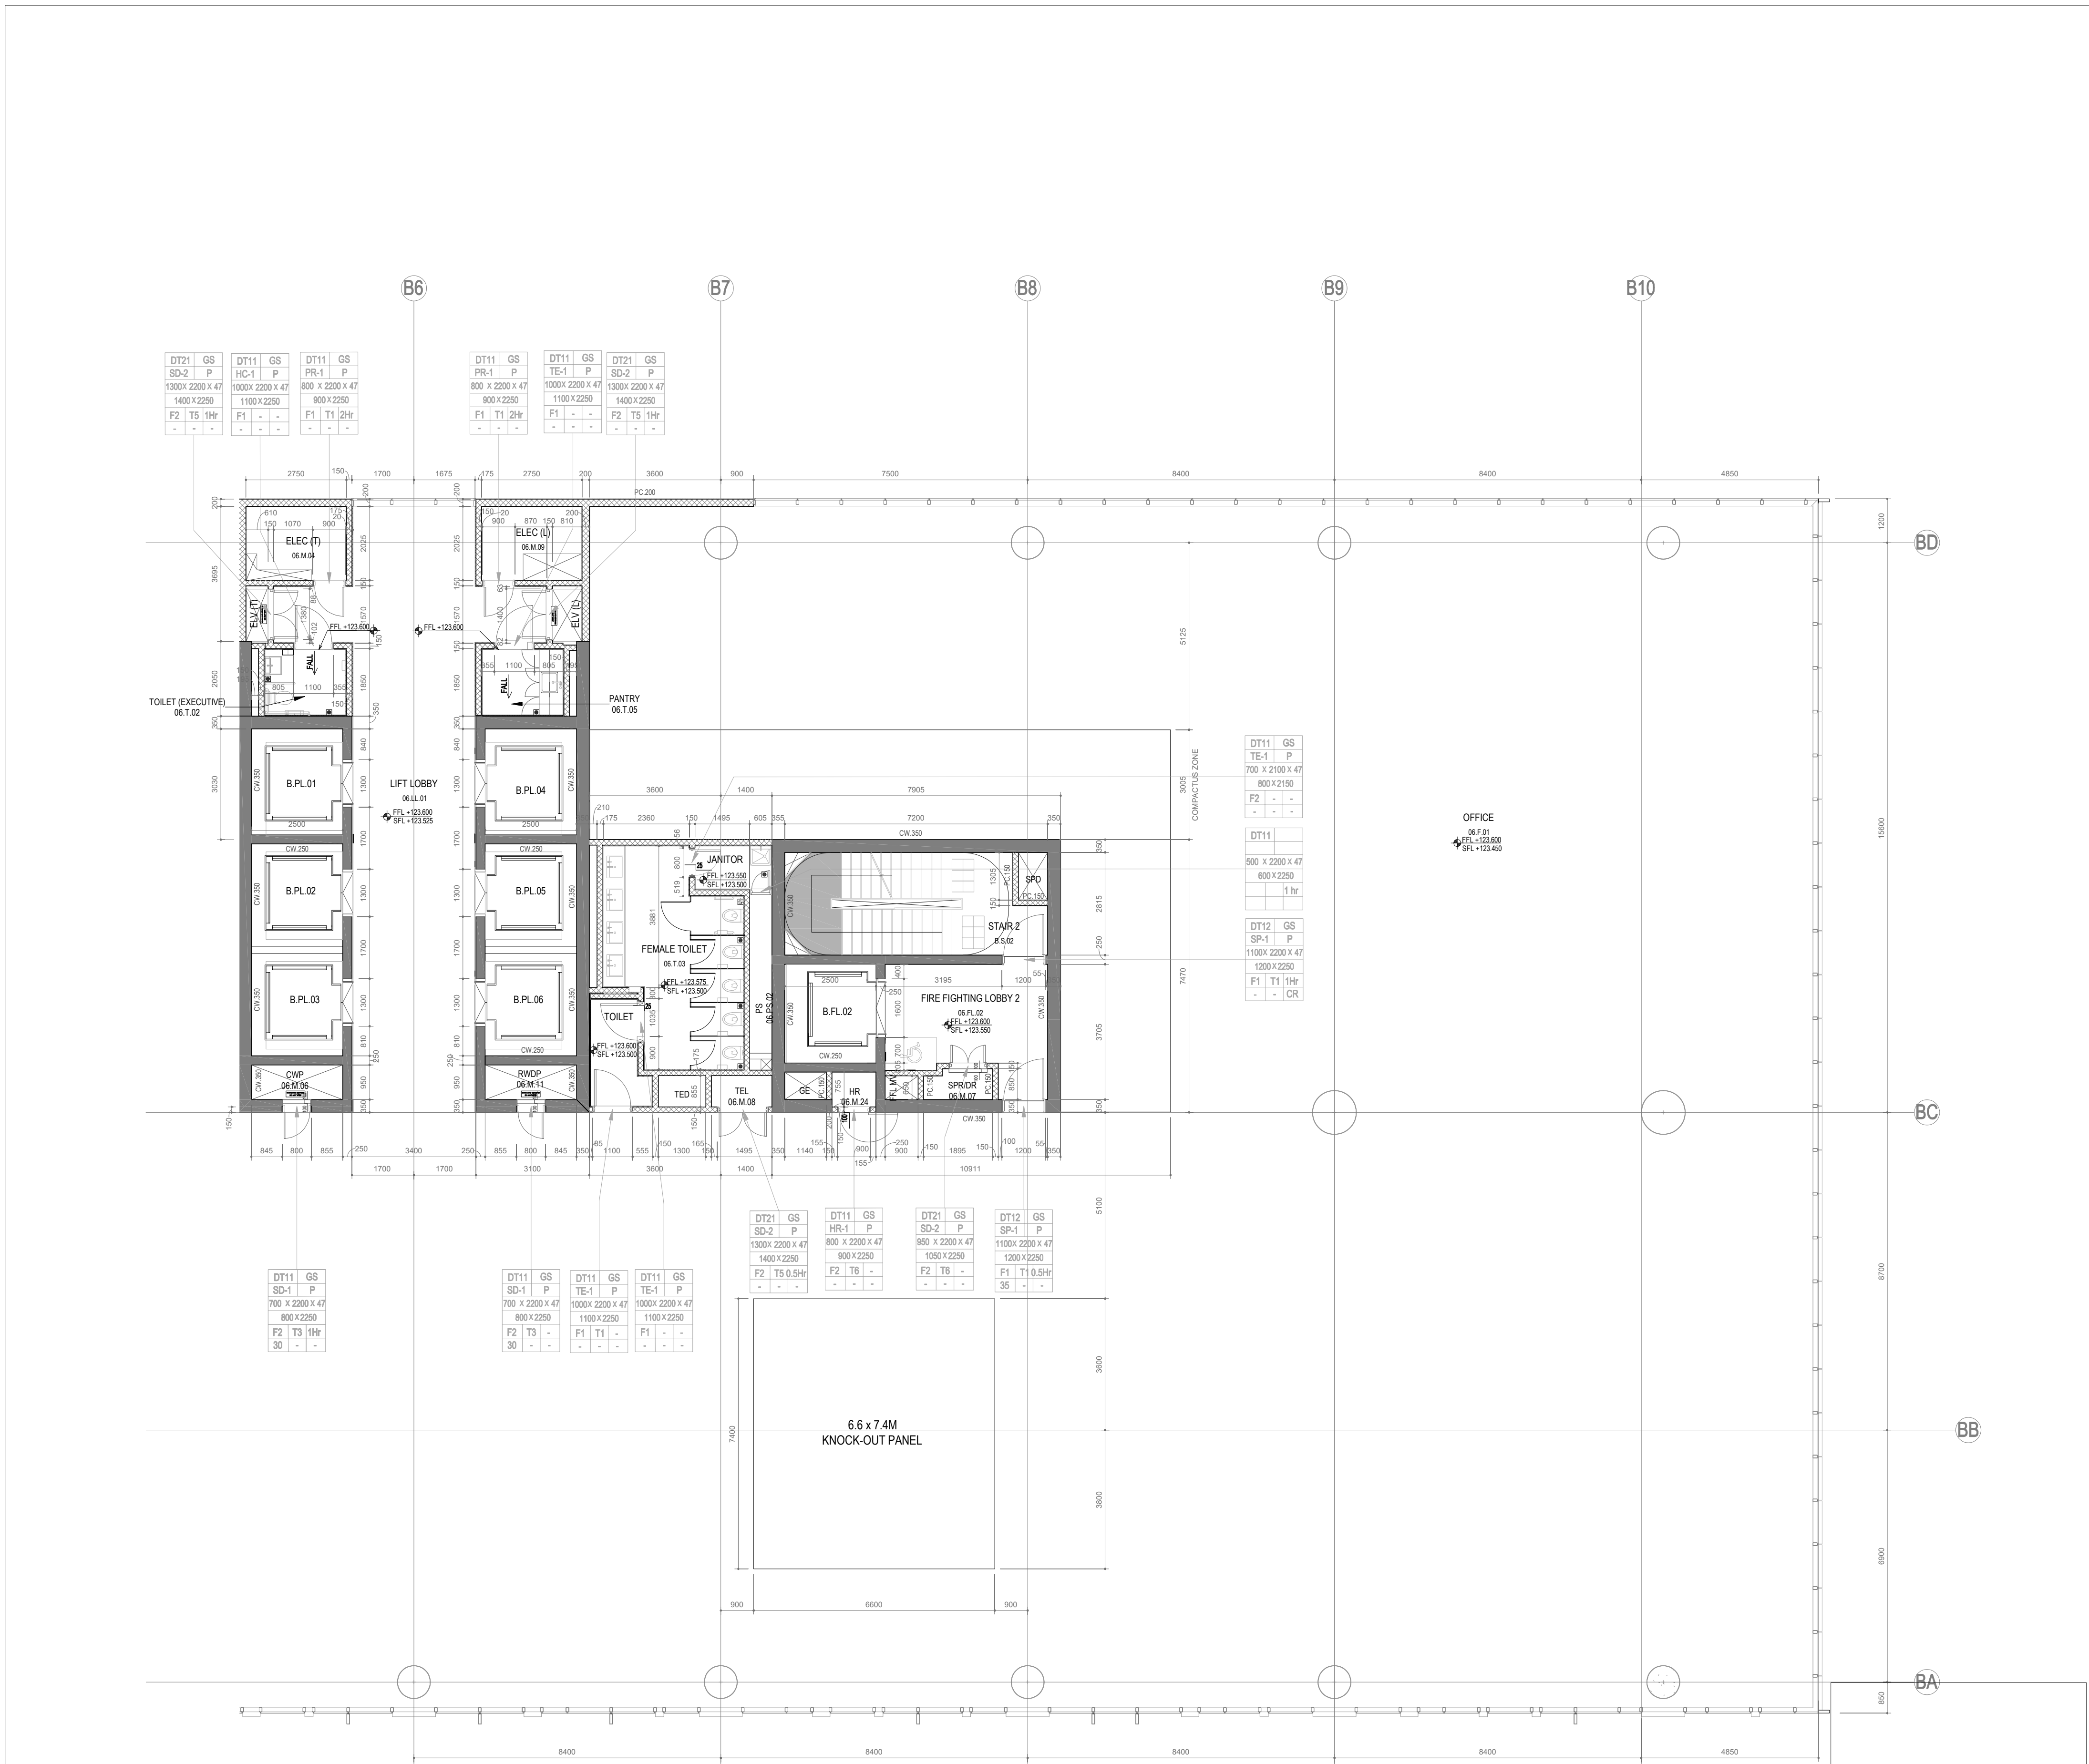

1 6TH STOREY WALL AND KERB SETTING OUT_PLOT B4
SCALE 1:100

[illegible]