

### 6TH STOREY - FIRE PROTECTION SYSTEM PLAN (PLOT B4)

SCALE 1:100

[illegible]

## AS BUILT

COMPANY: DP ARCHITECTS PTE LTD	
NAME & DESIGNATION	SIGNATURE

COMPANY: MEINHARDT SINGAPORE PTE LTD	
NAME & DESIGNATION	SIGNATURE

RTO NAME	SIGNATURE

COMPANY: _____	
NAME & DESIGNATION	SIGNATURE

COMPANY: _____	
NAME & DESIGNATION	SIGNATURE


  

COMPANY: HEXAGON CONSTRUCTION PTE LTD.	
NAME & DESIGNATION	SIGNATURE

SUBCON COMPANY: CHUBB ENGINEERING PTE LTD.	
NAME & DESIGNATION	SIGNATURE

## KEY PLAN

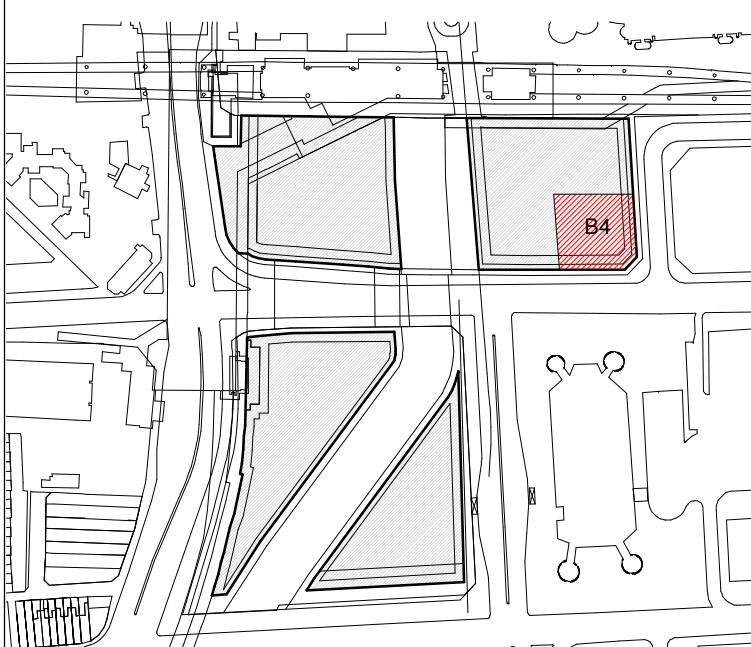

DEVELOPER/LANDOWNER:



ROMA CENTRAL PTE LTD  
MILANO CENTRAL PTE LTD  
VERONA CENTRAL PTE LTD  
60 ANSON ROAD, #17-01, MAPLETREE  
ANSON, SINGAPORE 079914  
TEL: +65 6671 6600 FAX: +65 6238 530

**ARCHITECTURAL:** DP ARCHITECTS PTE LTD  
 6 RAFFLES BOULEVARD #04-100 MARINA SQUARE, SINGAPORE 039594  
 TEL : +65 6338 3988 FAX : +65 6337 9989

**CIVIL & STRUCTURAL ENGINEER:**  
**ARUP** ARUP SINGAPORE PTE LTD  
10 HOE CHIANG ROAD, #26-01,  
SINGAPORE 089315  
TEL: +65 6411 2500 FAX: +65 6411 2500

M&E ENGINEER: MEINHARDT SINGAPORE PTE LTD  
 168 JALAN BUKIT MERAH, #09-01,  
 SURBANA ONE, SINGAPORE 150168  
 TEL: +65 6273 5255 FAX: +65 6274 0788

MAIN CONTRACTOR:  
 **HEXA CON** CONSTRUCTION  
PRIVATE LIMITED

432 BALESTIER ROAD #02-432, PUBLIC MANSION SINGAPORE 329813  
TEL: 6251 9288 FAX: 6253 1638  
T/X: RS 38737  
E-MAIL: [hexacon@hexacon.com.sg](mailto:hexacon@hexacon.com.sg)

**SUB-CONTRACTOR:**

**Chubb**  
Global Insurance

**Chubb Singapore Pte Ltd**  
28, Teban Gardens Crescent  
Singapore 608926  
Tel: 62928421 Fax: 6298 7310

**PROJECT TITLE:**  
PROPOSED MIXED-USE COMMERCIAL DEVELOPMENT  
COMPRISING SHOPPING OFFICE / RESIDENTIAL AND  
CARPARKS WITH AIRSPACE / SUBTERRANEAN  
CONNECTIONS ACROSS SIMS AVENUE ON LOTS 6991M  
& 7373T MK23 AT PAYA LEBAR ROAD / SIMS AVENUE  
(GEYLANG PLANNING AREA)

DRAWING TITLE:  
FIRE PROTECTION SERVICES - PLOT B4  
6TH STOREY PLAN  
(SPRINKLER/ HOSEREEL & DRY RISER SYSTEM)

DRAWN BY:	NAI
CHECKED BY:	NEO
APPROVED BY:	DAVE

DRAWING NO: HEX\_FP\_SHD\_B.2000.06.4

PROJECT NO: 251878	DATE: 30 AUG 2018
--------------------	-------------------

SCALE:	PAPER SIZE	SHEET NO	REV
1:100	A1	32	AA

C:\Users\acePL\ Desktop\CHUBB\PLOT B (MAIN FOLDER)\PLOT B\CHUBB EB 20M B 0.06 BVT AS B111 T/15 9 2019\ 01