6TH STOREY - BUILDING MANAGEMENT SYSTEM PLAN

SCALE 1:200

LEGEND:

- DDC PANEL
- 50X50MM BMS TRUNKING
- 20MM CONDUIT PIPE
- VAV (SUPPLY BY ACMV CONTRACTOR)
- BTU — BTU FLOW METER
- TS — THERMOSTAT
- T — TEMPERATURE SENSOR
- CO2 — CO2 SENSOR
- IAQ — IAQ CONTROLLER
- RH — RELATIVE HUMIDITY SENSOR

Number of Thermostat at Level 6	
Thermostat	63

AS BUILT

COMPANY: DP ARCHITECTS PTE LTD
NAME & DESIGNATION SIGNATURE

COMPANY: MEINHARDT SINGAPORE PTE LTD
NAME & DESIGNATION SIGNATURE
RTO NAME SIGNATURE

COMPANY: _____
NAME & DESIGNATION SIGNATURE

COMPANY: _____
NAME & DESIGNATION SIGNATURE

COMPANY: HEXACON CONSTRUCTION PTE LTD.
NAME & DESIGNATION SIGNATURE
SUBCON COMPANY: KAER PTE LTD. (BMS)
NAME & DESIGNATION SIGNATURE

KEY PLAN

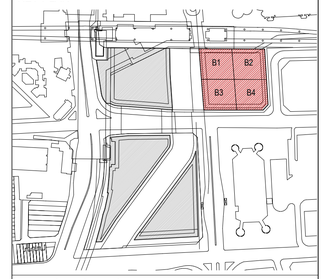

DEVELOPER/LANDOWNER:
ROMA CENTRAL PTE LTD
MILANO CENTRAL PTE LTD
VERONA CENTRAL PTE LTD
60 ANSON ROAD, #17-01, MAPLETREE ANSON, SINGAPORE 079914
TEL: +65 6671 6600 FAX: +65 6238 5301

ARCHITECTURAL:
DP ARCHITECTS PTE LTD
6 RAFFLES BOULEVARD #04-100 MARINA SQUARE, SINGAPORE 039594
TEL: +65 6338 3988 FAX: +65 6337 9989

CIVIL & STRUCTURAL ENGINEER:
ARUP SINGAPORE PTE LTD
10 HOE CHIANG ROAD, #26-01, SINGAPORE 089315
TEL: +65 6411 2500 FAX: +65 6411 2501

M&E ENGINEER:
MEINHARDT SINGAPORE PTE LTD
168 JALAN BUKIT MERAH, #09-01, SURBANA ONE, SINGAPORE 150168
TEL: +65 6273 5255 FAX: +65 6274 0788

MAIN CONTRACTOR:
HEXACON CONSTRUCTION PRIVATE LIMITED
432 BALESTIER ROAD #02-432, PUBLIC MANSION SINGAPORE 329813
TEL: 6251 9288 FAX: 6253 1638
T/X: RS 38737
E-MAIL: hexacon@hexacon.com.sg

SUB-CONTRACTOR:
KAER PTE LTD
SOLARIS, 1 FUSIONOPOLIS WALK, #02-11 NORTH TOWER, SINGAPORE 138628
TEL: +65 6735 5640 FAX: +65 6735 5420

PROJECT TITLE:
PROPOSED MIXED-USE COMMERCIAL DEVELOPMENT COMPRISING SHOPPING OFFICE / RESIDENTIAL AND CARPARKS WITH AIRSPACE / SUBTERRANEAN CONNECTIONS ACROSS SIMS AVENUE ON LOTS 6991M & 7373T MK23 AT PAYA LEBAR ROAD / SIMS AVENUE (GEYLANG PLANNING AREA)

DRAWING TITLE:
BUILDING MANAGEMENT SYSTEM
6TH STOREY
PLOT B

DRAWN BY:	LX
CHECKED BY:	MESIAH
APPROVED BY:	RAJ
DRAWING NO:	HEX_BM_SHD_B.2000.06.0
PROJECT NO: 251878	DATE: 24/08/18
SCALE: 1:200	PAPER SIZE: A1
SHEET NO: 6	REV: AA

DATE	REV.	DESCRIPTION	DRAWN	CHECKED
24/08/18	AA	AS-BUILT SUBMISSION	LX	MESIAH

C:\Users\LXiong\Documents\00 Project_RL\207 BM\Plot B\Arch Submission\AAE_BMS_00M_B.0.06_R17.rvt