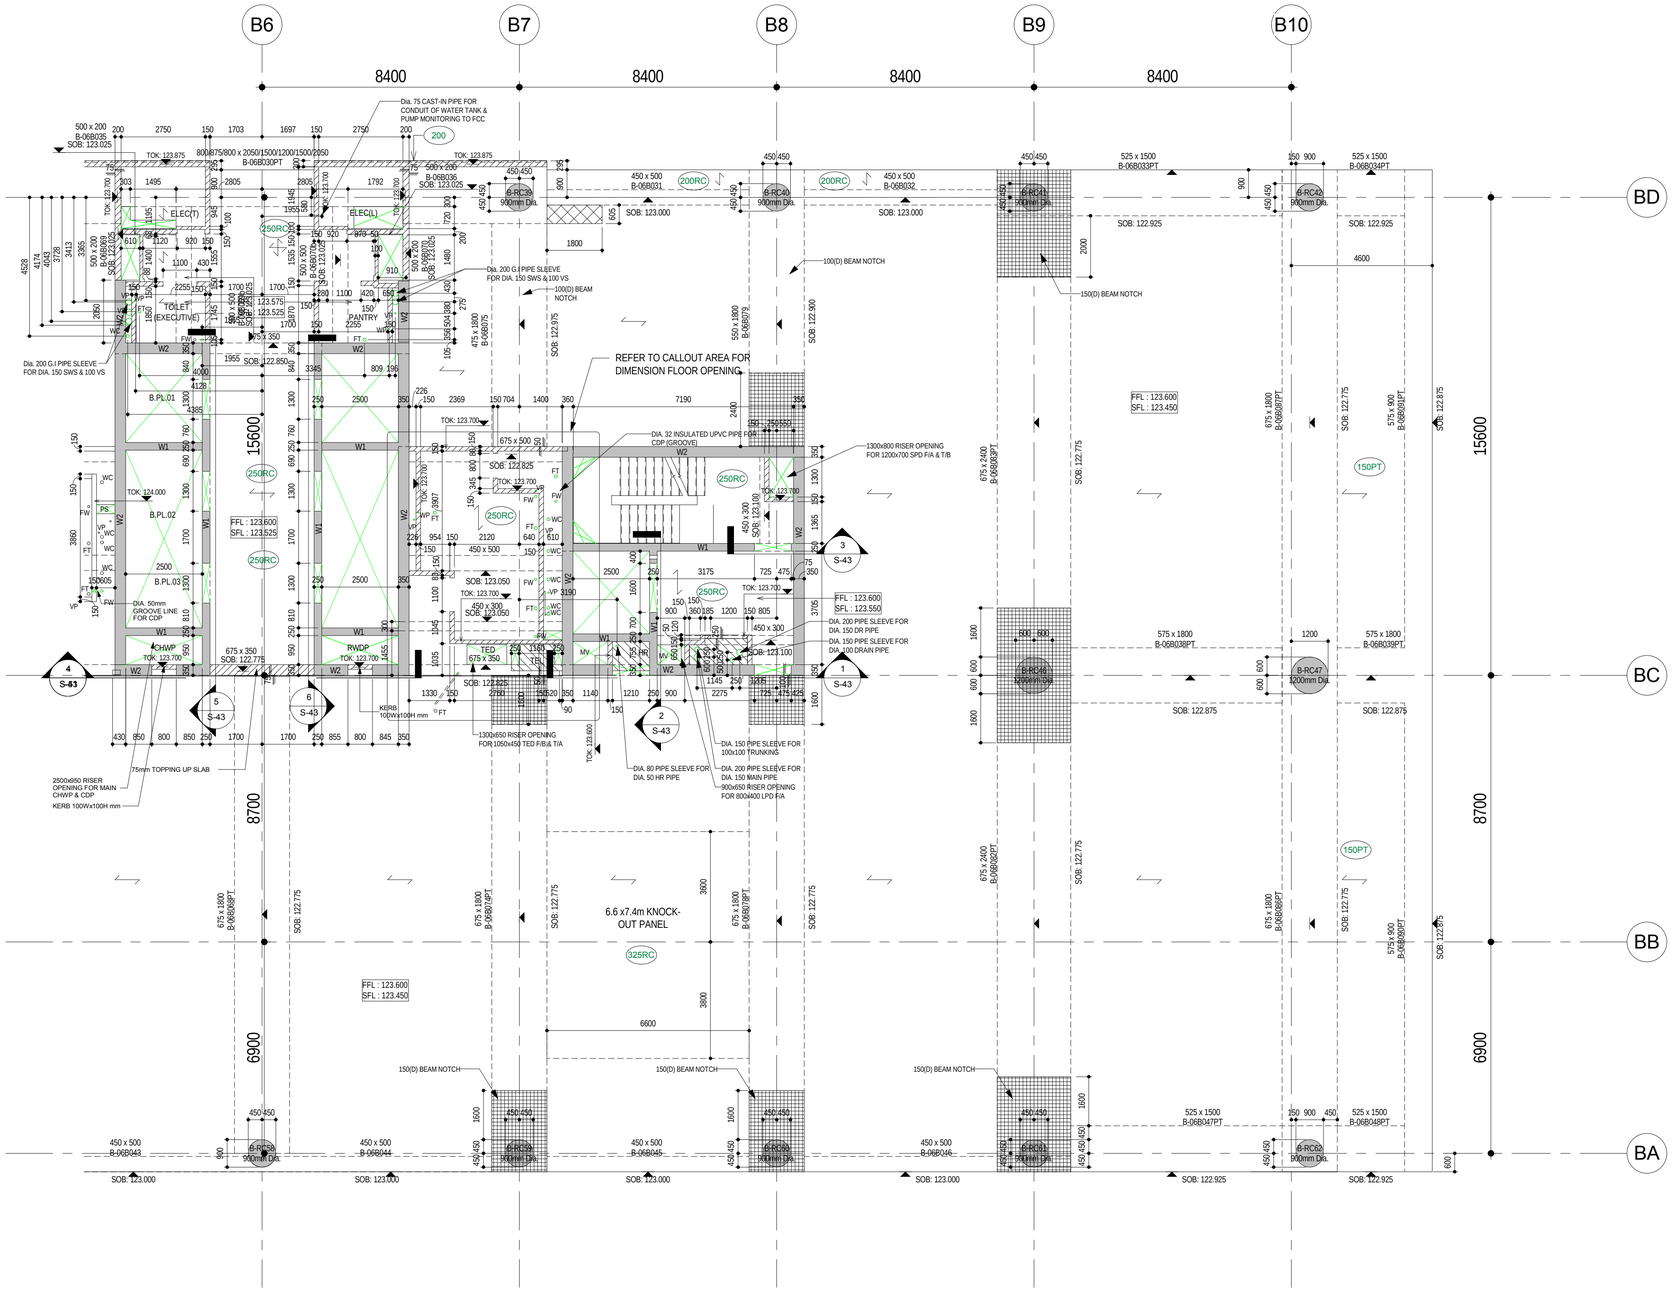

1 LEVEL 6 _CONCRETE BODY PLAN - ZONE B4

1 : 100

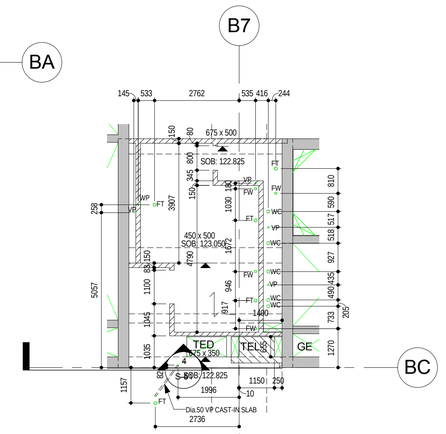

2 CBP OPENING AT LEVEL 6 FEMALE TOILET - SOUTH TOWER (GL B7/BC)

1 : 100

Notes:

1. All slabs to be 200 Thk PT UON..
2. All beams to be RC UON.
3. All detention tanks to be constructed from waterproof concrete.
4. For precast panel detail refer to dwg no. ARP_ST_DWG_B.00.0_2800
5. Typical corbel detail refer to Drawing no. ARP_ST_DWG_B.00.0_0104
   Setting of corbel to be verified by non-suspended slab thickness and finishes thickness.
6. Openings based on system models dated 01/11/2016
7. TOW for parapet walls for planter walls & parapet walls are 500mm & 1100mm respectively.
   Add 25mm for all planter wall for finishes.

RC KERB

150MM NOTCH IN BEAM SOFFIT UNLESS OTHERWISE STATED.

INDICATES PT STRESSING POCKET (BEAM WIDTH x 1800mm LONG) TO BE CAST BACK AFTER STRESSING.

PLINTH

FT - Ø100 CAST-IN FT

WC - Ø100 CAST-IN WC

FW - Ø75 CAST-IN FW

FW IN SHAFT - Ø50 CAST-IN FW

VP - Ø50 CAST-IN VP

WP - Ø50 CAST-IN WP

STRUCTURAL DRAWINGS BASED ON THE FOLLOWING; PLOT B :

-DPA Model(Updated 09 Jan 2017)
-Arup Model (Updated 26 Sep 2016)
-DPA_AR_DWG_B.0.06_1100_PDF (Rev C)
-DPA_AR_DWG_B.4.06_2000_PDF (Rev C)
-DPA_ST_DWG_B.4.06_2100_PDF (Rev B)
-DPA_AR_DWG_B.0.06_6000_PDF (Rev D)
-ARP_ST_DWG_B.04.0_1114_PDF (Rev 05)
-HEX_OP_SHD_B.2000.06.0_PDF (Rev 0)
-HEX_MV_SHD_B.7002.06.0_PDF (Rev.A)

AS BUILT

COMPANY: DP ARCHITECTS PTE LTD
NAME & DESIGNATION SIGNATURE

COMPANY: ARUP SINGAPORE PTE LTD
NAME & DESIGNATION SIGNATURE
RTO NAME SIGNATURE

COMPANY: MEINHARDT SINGAPORE PTE LTD
NAME & DESIGNATION SIGNATURE
RTO NAME SIGNATURE

COMPANY:
NAME & DESIGNATION SIGNATURE

COMPANY:
NAME & DESIGNATION SIGNATURE

COMPANY: HEXACON CONSTRUCTION PTE LTD
NAME & DESIGNATION SIGNATURE
SUB CONTRCTOR :
NAME & DESIGNATION SIGNATURE

KEY PLAN

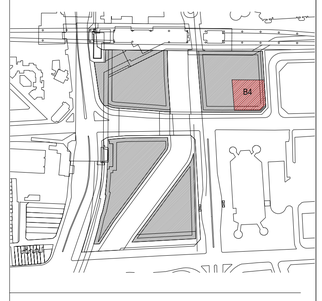

DEVELOPER/LANDOWNER:
ROMA CENTRAL PTE LTD
MILANO CENTRAL PTE LTD
VERONA CENTRAL PTE LTD
60 ANSON ROAD, #17-01, MAPLETREE ANSON, SINGAPORE 079914
TEL: +65 6671 6600 FAX: +65 6238 5301

ARCHITECTURAL:
DP ARCHITECTS PTE LTD
6 RAFFLES BOULEVARD #04-100 MARINA SQUARE, SINGAPORE 039594
TEL: +65 6338 3988 FAX: +65 6337 9989

CIVIL & STRUCTURAL ENGINEER:
ARUP SINGAPORE PTE LTD
10 HOE CHIANG ROAD, #26-01, SINGAPORE 089315
TEL: +65 6411 2500 FAX: +65 6411 2501

M&E ENGINEER:
MEINHARDT SINGAPORE PTE LTD
168 JALAN BUKIT MERAH, #09-01, SURBANA ONE, SINGAPORE 150168
TEL: +65 6273 5255 FAX: +65 6274 0788

MAIN CONTRACTOR
HEXACON CONSTRUCTION PRIVATE LIMITED
432 BALESTIER ROAD #02-432, PUBLIC MANSION SINGAPORE 329813
TEL: 6251 9288 FAX: 6253 1638
T/X: RS 38737
E-MAIL: hexacon@hexacon.com.sg

PROJECT TITLE:
PROPOSED MIXED-USE COMMERCIAL DEVELOPMENT COMPRISING SHOPPING OFFICE / RESIDENTIAL AND CARPARKS WITH AIRSPACE / SUBTERRANEAN CONNECTIONS ACROSS SIMS AVENUE ON LOTS 6991M & 7373T MK23 AT PAYA LEBAR ROAD / SIMS AVENUE (GEYLANG PLANNING AREA)

DRAWING TITLE:
CONCRETE BODY PLAN (SETTING OUT)
LEVEL 6 - ZONE B4 - PLOT B
GL B6-B10/BA-BD

DRAWN BY:	JESS
CHECKED BY:	MAK/MIKE/EROS
APPROVED BY:	JASON
DRAWING NO:	HEX_ST_SHD_B.2100.06.4
PROJECT NO: 251878	DATE: 20-6-2018

SCALE:	PAPER SIZE	SHEET NO	REV
1 : 100	A1	S-42	AA

DATE	REV.	DESCRIPTION	DRAWN	CHECKED
4-7-2018	AA	AS-BUILT DRAWING SUBMISSION	MAY THU	NIC

D:\MAY THU KYAW\HEXACON (Yangon Team)\HEXACON projects\PQ Project\CPB FOR Update\PLOT BASE_S-30M_(1:100)_07102018.dwg for A1 BW TBB Stock.ctt